


Mint Farm Regional Water Treatment Plant

Dissolved Oxygen Injection

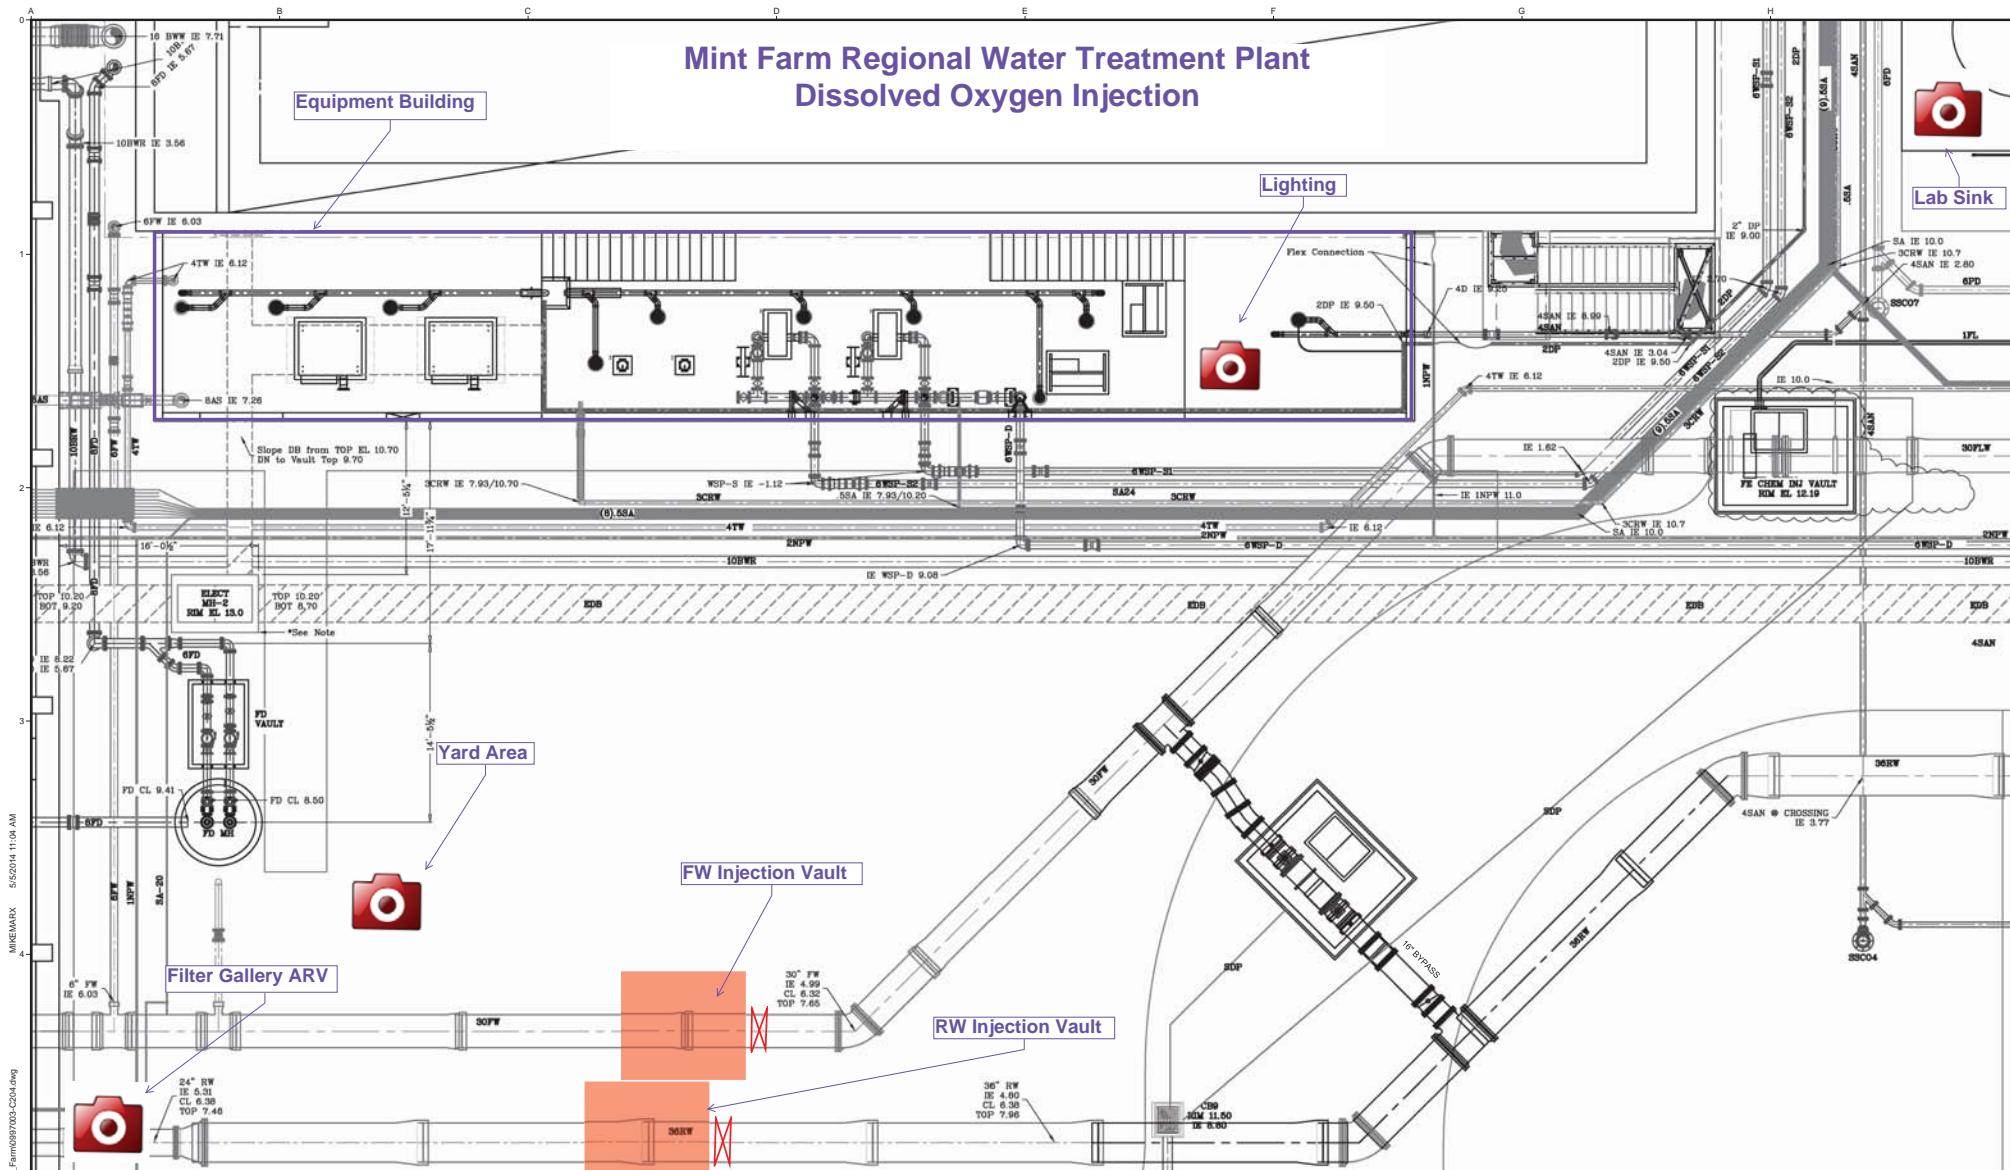

USE OF DOCUMENTS
THE DOCUMENT, INCLUDING THE INCORPORATED DESIGNS, IS AN INSTRUMENT OF SERVICE FOR THIS PROJECT AND SHALL NOT BE USED FOR ANY OTHER PURPOSE. THE CONTRACTOR IS RESPONSIBLE FOR THE ACCURACY AND COMPLETENESS OF THE INFORMATION PROVIDED.
KENNEDY/JENKS CONSULTANTS.

RECORD DRAWING
These Record Drawings have been prepared based on information provided by the contractor and others. Kennedy/Jenks Consultants has not verified the accuracy or completeness of information provided to them and does not warrant the accuracy or completeness of these Record Drawings. Users of these Record Drawings assume all risk of loss resulting from their use.

RECORD DRAWING NO.	REVISION NO.	05/2014	KJ
REVISION		DATE	BY

SCALES
0 1"
0 25mm
IF THIS BAR IS NOT DIFFERENTLY SHOWN, ADJUST SCALES ACCORDINGLY.

DESIGNED
J. SNEDECOR
DRAWN
L. MARX
CHECKED

Longview
Washington
BIAON HILL
Water and Sewer District

Mint Farm
Regional Water Supply Project
Kennedy/Jenks Consultants
Seattle, Washington

Spherical Image Log
Photos Taken 11/15/2016
ch2m

FILE NAME:
0997003-C204
JOB NO.
0997003-00
DATE
DECEMBER 2013
SHEET OF
C204 258